

WENDOVER AIR FORCE BASE, DINING HALL
(Building No. 2515)
South of Interstate 80
Wendover
Tooele County
Utah

HABS NO. UT-125-^{BG}~~000~~

HABS
UTAH
23-WEN,
2BG-

PHOTOGRAPHS

WRITTEN HISTORICAL AND DESCRIPTIVE DATA

Historic American Buildings Survey
National Park Service
Rocky Mountain Regional Office
Department of the Interior
P.O. Box 25287
Denver, Colorado 80225

HISTORIC AMERICAN BUILDINGS SURVEY

HABS
UTAH
23-WEN
288-

Wendover Air Force Base,
Dining Hall
(Building No. 2515) BG
HABS No. UT-125-~~666~~
Page 1

The Dining Hall was built in 1945 at the corner of 11th and B street. The Dining Hall is a T-shaped building with a concrete foundation and floor, wooden walls and an asphalt roll roof. The 9,585-square-foot structure was of "semi-permanent" construction and had a capacity of 500. Fire protection was provided by extinguishers and a hydrant.

The multi purpose space of the Dining Hall was broken down in 1961 into 7,668 square feet for airmen and 1,917 square feet for officers. The main building measures 66 feet-7 inches by 109 feet-11 inches. Offsets measured 28 feet-5 inches by 30 feet-2 inches and the wings measure 36 feet-3 inches by 39 feet. At the back of the dining hall there are two latrines. The Dining Hall appears to be structurally sound. The following equipment was present during a 1990 inspection:

- 2 refrigerators
- 2 Montague Ovens
- 2 Chef gas-fired ranges with overhead fans.
- 2 Garland griddles
- 1 Hobart Fryer
- 1 Wells Fryer
- 1 large wooden table
- US Nash and US Bloomfield Pans
- 2 Triple Sinks
- 1 Double sink
- Ruudglas commercial heater
- Rheemglas commercial heater
- Cecilware warmer
- Silver King Beverage Cooler
- 4 wooden tables
- Coffee urn

WENDOVER AIR FORCE BASE,

DINING HALL

BUILDING NAME

UT-125-~~006~~ BG

HABS #


2515

BUILDING #

2

PG

NO SCALE

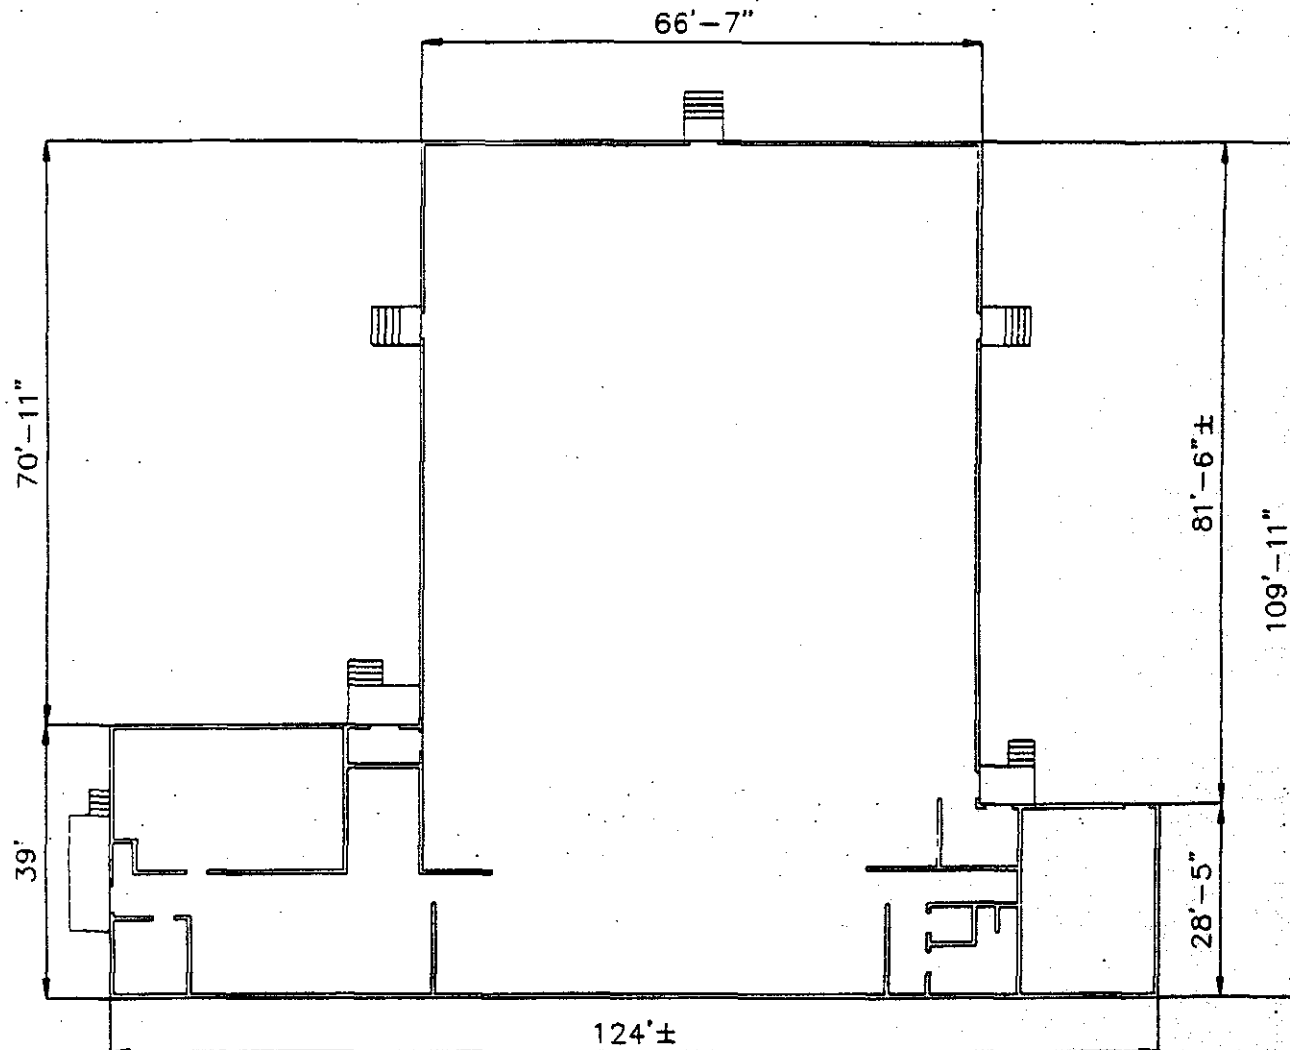

BUILDING SKETCH PLAN

**WENDOVER AIR FORCE BASE
WENDOVER, UTAH**

AIP PROJECT NO.

3-49-0046-01



BUSH AND GUGGELL, INC.
555 SOUTH 300 EAST
SALT LAKE CITY, UTAH 84111
PHONE: (801) 384-1212

DATE:
SEPT. 25, 1989



MULLER, SIRHALL & ASSOCIATES, INC.
AIRPORT CONSULTANTS
AURORA, COLORADO